


WOODLAND AVENUE



AERIAL VIEW

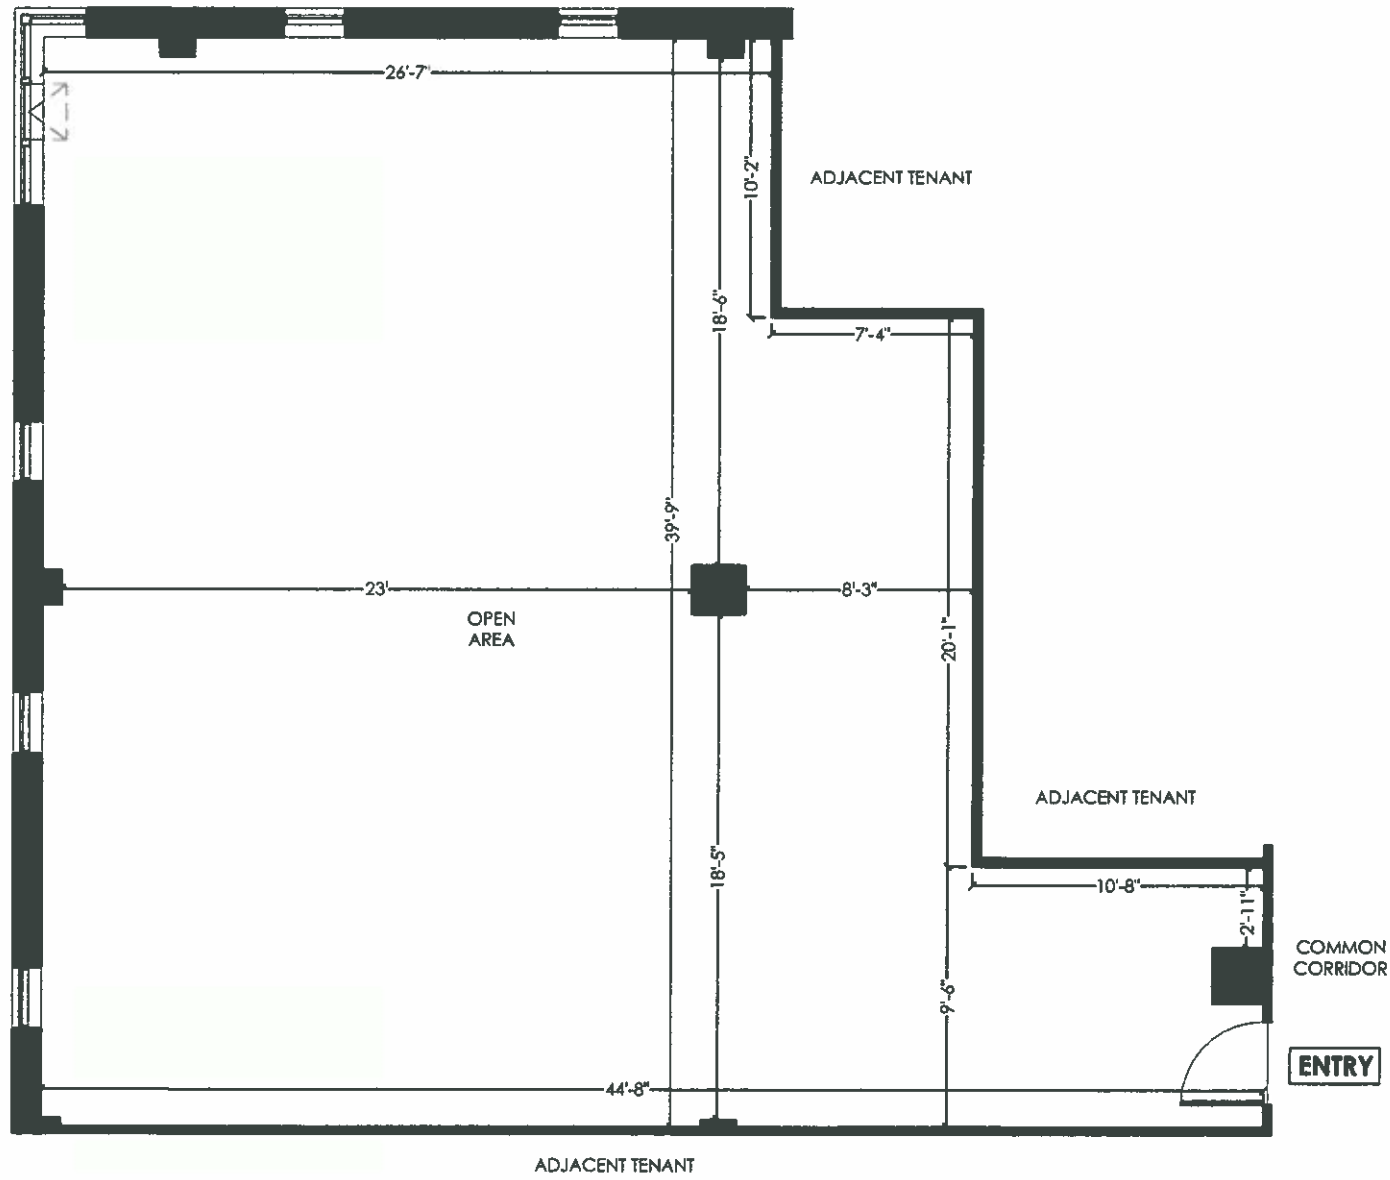

EXTERIOR ELEVATION

LEGEND

EXISTING WALLS

PREPARED FOR: District Realty Corporation,  
 Brokerage  
 ADDRESS: 2249 Carling Ave., Ottawa, ON  
 DATE: November 22, 2013  
 REVISION: n/a  
 PROJECT NUMBER: 100822  
 DRAWING SIZE: 8.5" x 14" - Legal Size



PREPARED BY: ECHOFLOORPLANS.COM



**ECHO FLOOR PLANS**  
 ■ As-Built Floor Plans  
 ■ Area Analysis  
 ■ Space Planning  
 www.ECHOFloorPlans.com