


LOWER LEVEL SUITE

1339 WELLINGTON STREET, OTTAWA, ON
(AS-BUILT FLOOR PLAN)

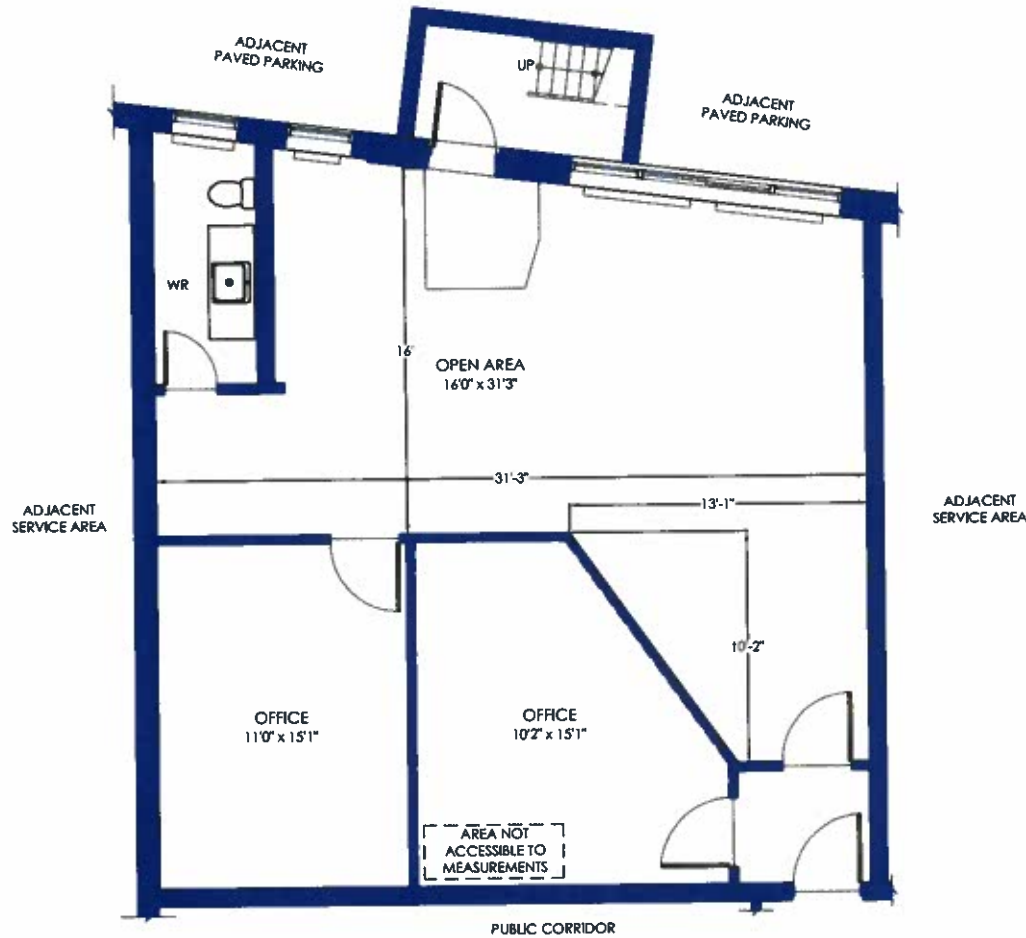

AERIAL VIEW



EXTERIOR ELEVATION

PREPARED FOR: District Realty Corporation.
Brokerage
ADDRESS: 1339 Wellington St., Ottawa, ON
DATE: September 1st, 2010
REVISION: n/a
PROJECT NUMBER: 00000
DRAWING SIZE: 8.5" x 14" - Legal Size



PREPARED BY: ECHOFLOORPLANS.COM



ECHO FLOOR PLANS
• As-Built Floor Plans
• Area Analysis
• Space Planning
www.ECHOFloorPlans.com