


UNITS 216, 218, 220 & 222

250 CITY CENTRE AVENUE, OTTAWA, ON
(AS-BUILT FLOOR PLAN)

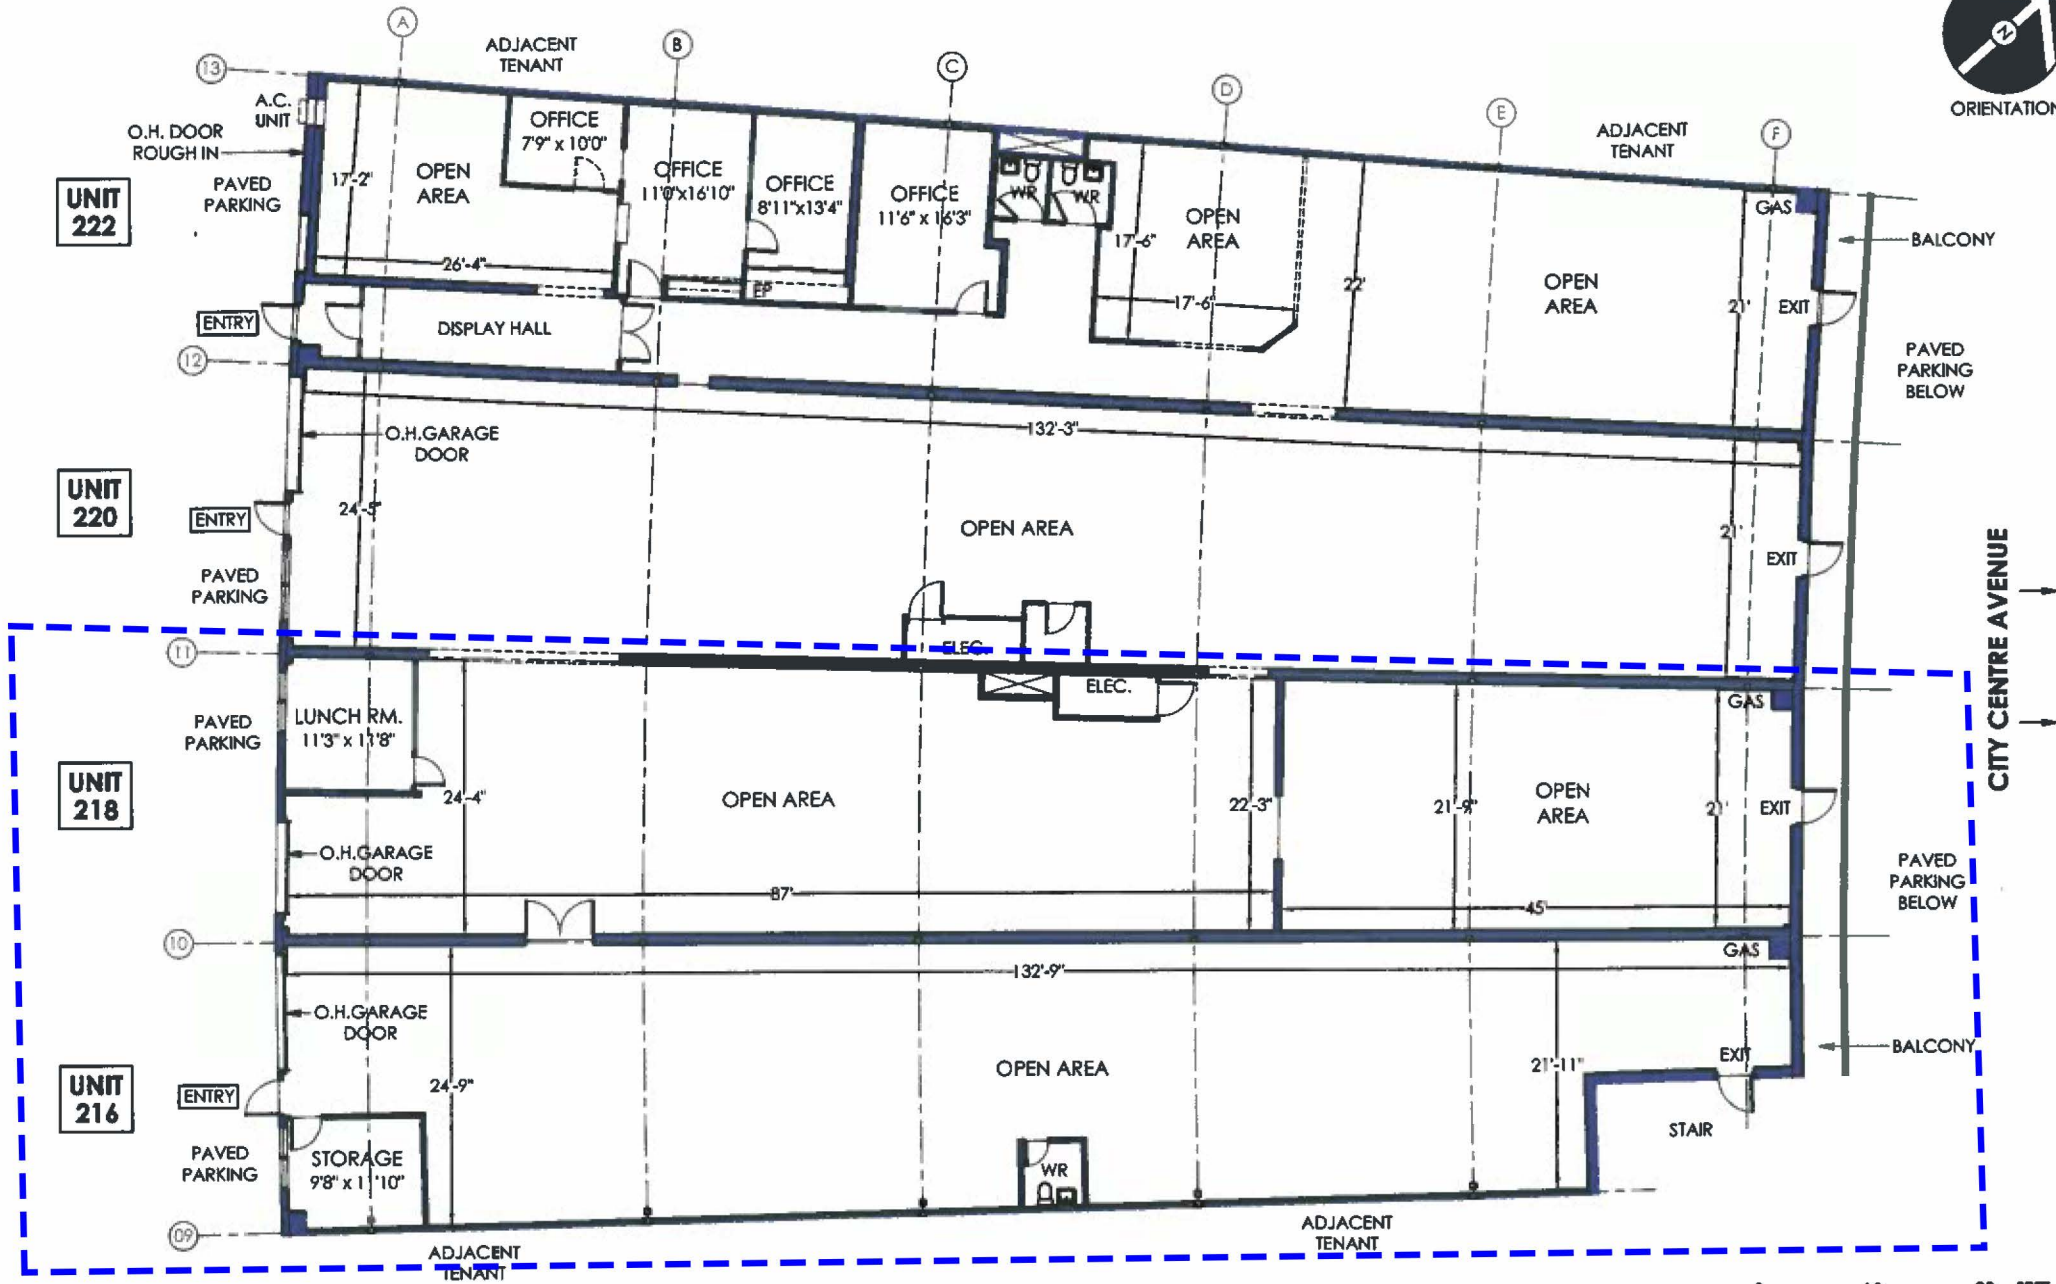

AERIAL VIEW



STREET VIEW



EXTERIOR VIEW FROM BRIDGE

PREPARED FOR: District Realty Corporation,
Brokerage
ADDRESS: 250 City Centre Avenue,
Ottawa, ON
DATE: December 31, 2010
REVISION: n/a
PROJECT NUMBER: 100102
DRAWING SIZE: 8.5" x 14" - Legal Size

NOTE:
This space was tenant occupied at time of measurement.
Not all areas were accessible to measurement.

0 10 20 FEET
0 3.05 6.10 METRES

PREPARED BY: ECHOFLOORPLANS.COM



ECHO FLOOR PLANS
 ■ As-Built Floor Plans
 ■ Area Analysis
 ■ Space Planning
 www.ECHOFloorPlans.com



AERIAL VIEW



STREET VIEW




EXTERIOR VIEW FROM BRIDGE

LEGEND:

- ELEC. ELECTRICAL
- TEL. TELECOMMUNICATIONS
- D.F. DRINK FOUNTAIN
- GAS NATURAL GAS LOCATION
- EXISTING WALLS

PREPARED FOR: District Realty Corporation, Brokerage
ADDRESS: 250 City Centre Avenue, Ottawa, ON
DATE: February 28, 2011
REVISION: n/a
PROJECT NUMBER: 100215
DRAWING SIZE: 8.5" x 14" - Legal Size

ECHO FLOOR PLANS
 ■ As-Built Floor Plans
 ■ Area Analysis
 ■ Space Planning
 www.EchoFloorPlans.com

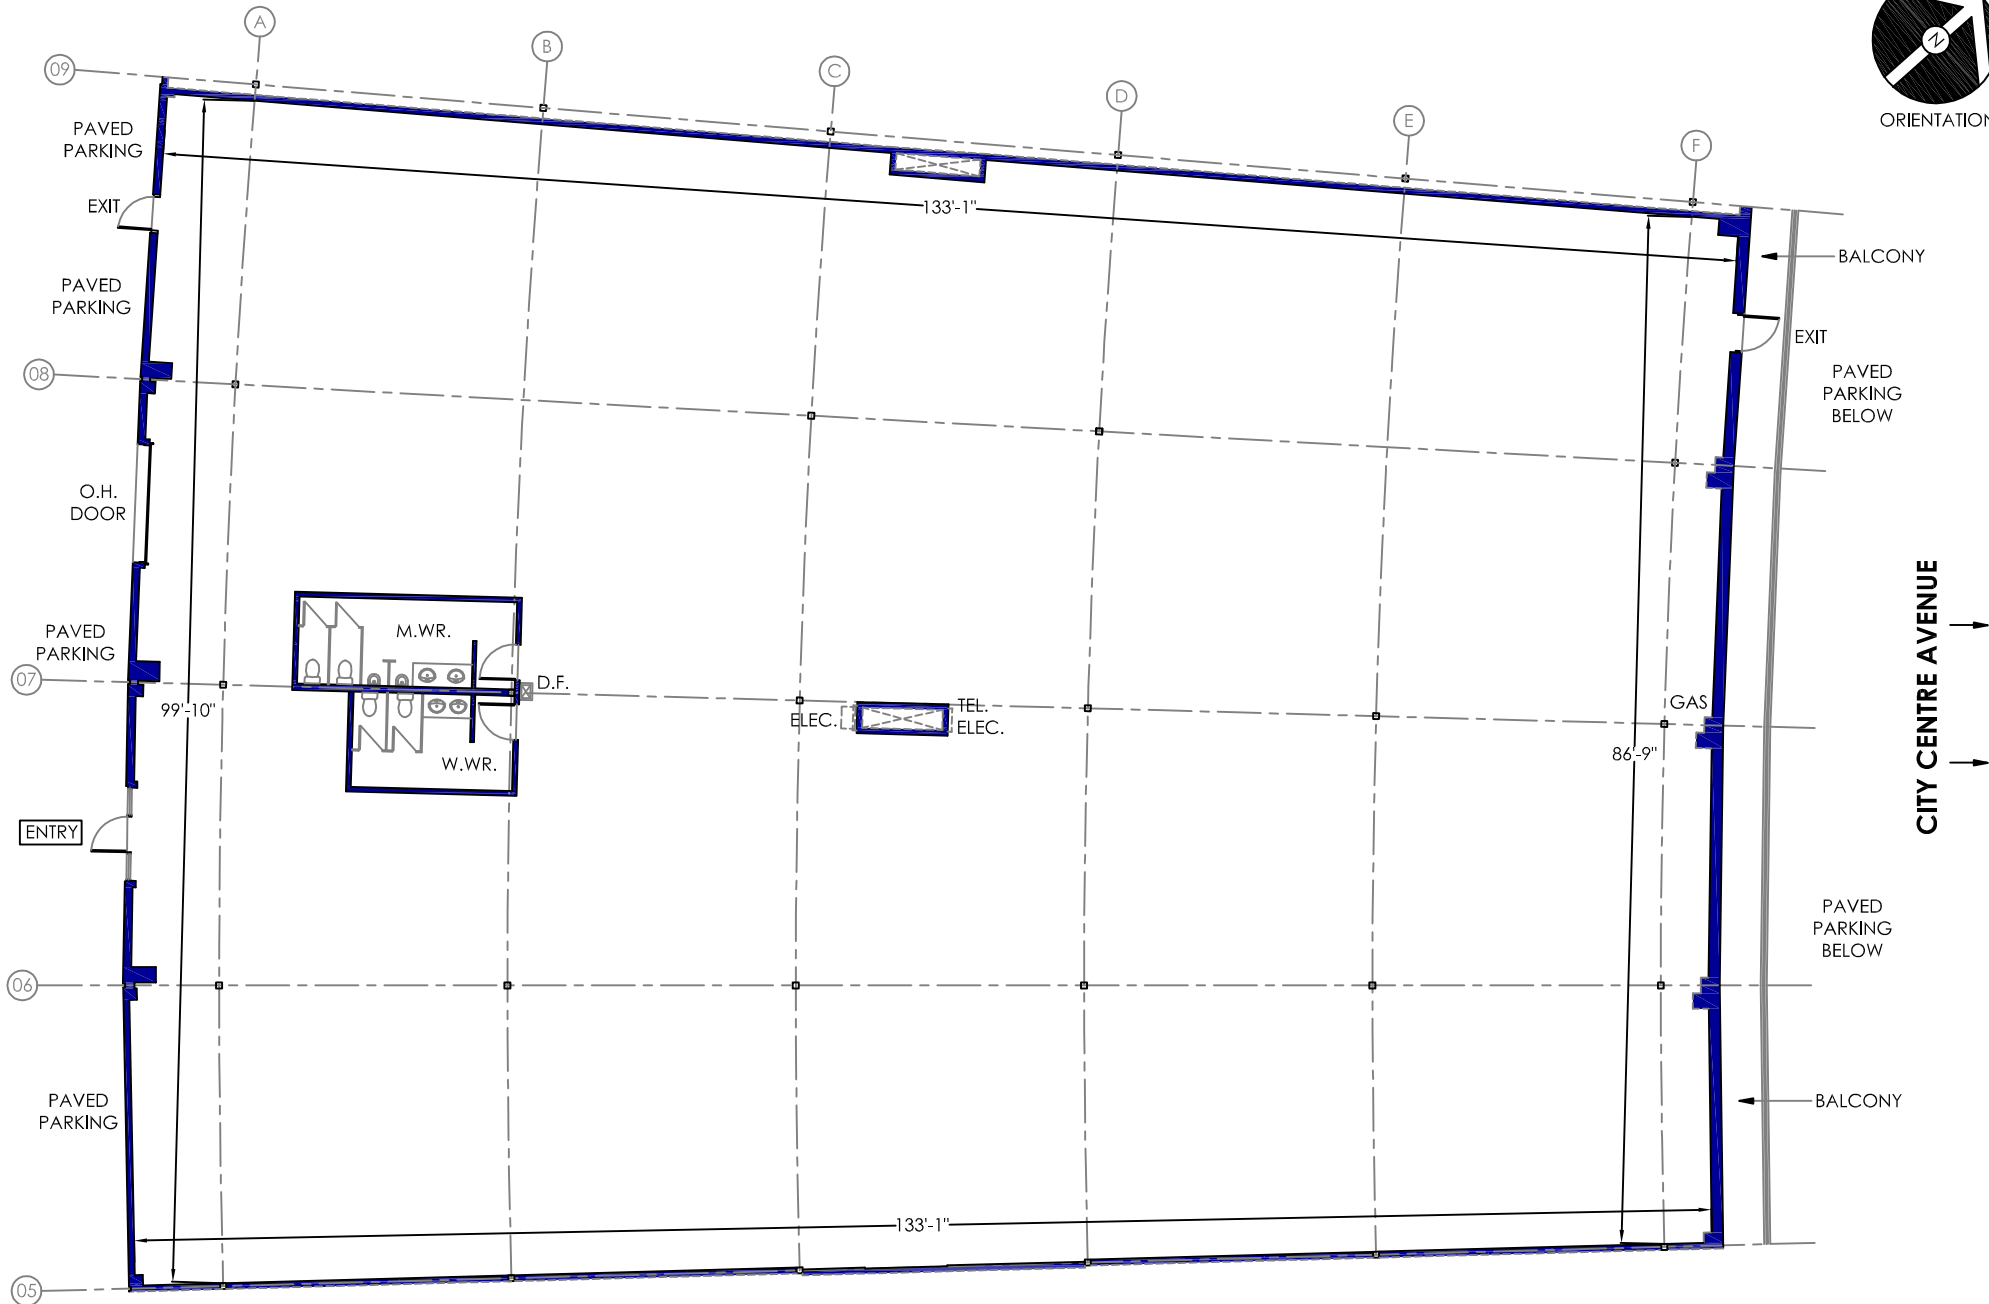

CITY CENTRE AVENUE

NOTE:
 This space was tenant occupied at time of measurement.
 Not all areas were accessible to measurement.

0 10 20 FEET
 0 3.05 6.10 METRES
 PREPARED BY: ECHOFLOORPLANS.COM