

UNITS 216, 218, 220 & 222

250 CITY CENTRE AVENUE, OTTAWA, ON
(AS-BUILT FLOOR PLAN)



ORIENTATION




AERIAL VIEW



STREET VIEW



EXTERIOR VIEW FROM BRIDGE

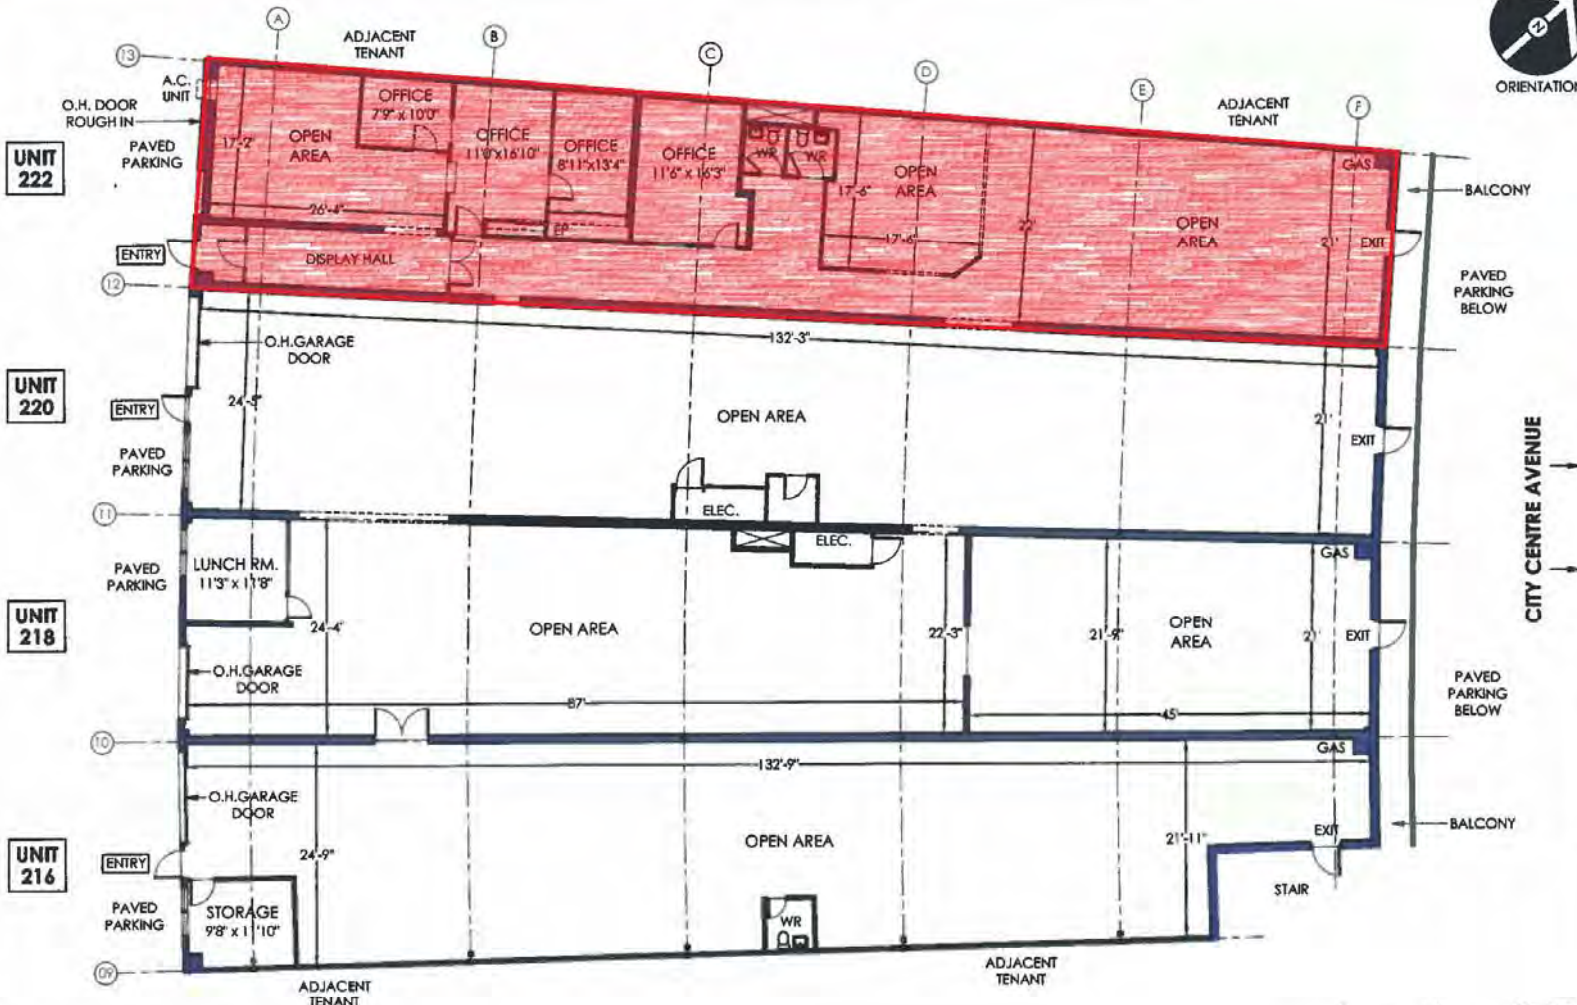

NOTE:
This space was tenant occupied at time of measurement.
Not all areas were accessible to measurement.

0 10 20 FEET
0 3.05 6.10 METRES
PREPARED BY: ECHOFLOORPLANS.COM

ECHO FLOOR PLANS
 ■ As-Built Floor Plans
 ■ Area Analysis
 ■ Space Planning
 www.ECHOFloorPlans.com

PREPARED FOR: District Realty Corporation,
 Brokerage
 ADDRESS: 250 City Centre Avenue,
 Ottawa, ON
 DATE: December 31, 2010
 REVISION: n/a
 PROJECT NUMBER: 100102
 DRAWING SIZE: 8.5" x 14" - Legal Size