


KEY PLAN

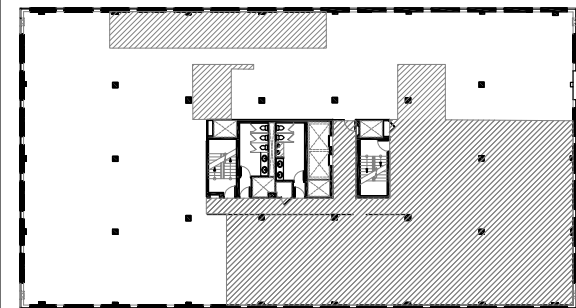

04	ISSUED AS BUILT	15/04/2016
03	ISSUED FOR CONSTRUCTION	23/09/2015
02	ISSUED FOR PERMIT & TENDER	08/09/2015
01	ISSUED FOR 99% REVIEW	03/09/2015

REV	DESCRIPTION	DATE
-----	-------------	------

REVISION TABLE

THIS DRAWING TO BE READ IN CONJUNCTION WITH THE CONSTRUCTION MANUAL.

THIS DRAWING IS THE PROPERTY OF 4TÉ INC. AND ALL COPYRIGHT IS RESERVED.

CE DESSIN EST LA PROPRIÉTÉ DE 4TÉ INC. ET TOUS DROITS DE RÉPRODUCTION SONT RÉSERVÉS.

DIMENSIONS ON THIS DRAWING FOR ESTIMATING PURPOSES ONLY. IT IS THE RESPONSIBILITY OF EACH CONTRACTOR AND SUB-CONTRACTOR TO CHECK ALL DIMENSIONS AND CONDITIONS ON SITE.

LES DIMENSIONS SUR CE DÉSSIN SONT UNIQUEMENT POUR ÉTABLIR UN DÉVIS. LES ENTREPRENEURS DEVRONT PRENDRE LEURS PROPRES MESURES SUR LES LIEUX ET EN ÊTRE RESPONSABLES.

4TÉ INC. BCIN#

28700

SIGNATURE: _____ BCIN# _____



73 Breezehill Avenue North
Ottawa, ON K1Y 2H6
tel: 613.232.4499
fax: 613.232.4187
www.4te.ca

Project Title / Titre du Projet

**I-SIGHT CUSTOMER EXPRESSIONS
EXPANSION 2015**
2255 CARLING AVE
SUITE 500
OTTAWA, ONTARIO

Drawing Title / Titre du Dessin

**FURNITURE
PLAN**

Date:
AUGUST 12, 2015


Scale / Échelle
1/8" = 1'

Drawn by / Tracé par
MM

Checked by / Vérifié par
NS

Reference / Référence
CEC-4370

Drawing No.:

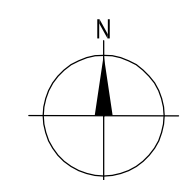

D-01