SUITE 603

250 CITY CENTRE AVE., OTTAWA, ON
(AS-BUILT FLOOR PLAN)

0 5 10 15 FEET
0 1.52 3.05 4.57 METRES

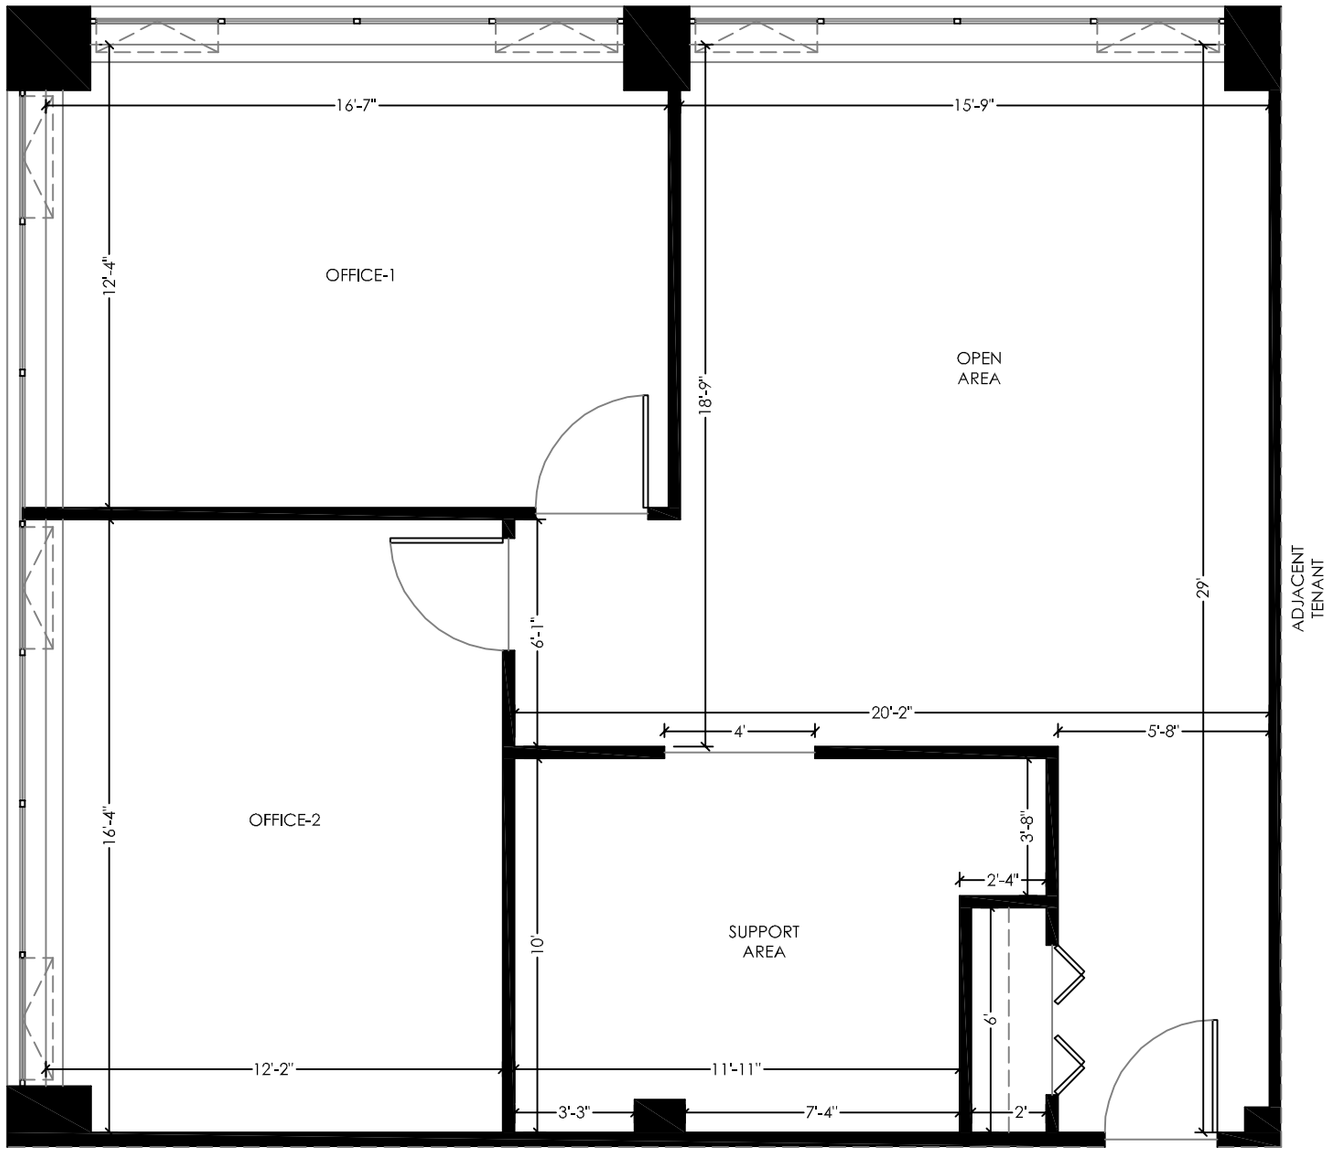

STREET VIEW

MAIN LOBBY VIEW

LEGEND:

EXISTING WALLS

PREPARED FOR: District Realty Corporation, Brokerage
ADDRESS: 250 City Centre Ave., Ottawa,ON
DATE: September 11, 2019
REVISION: n/a
PROJECT NUMBER: 200412
DRAWING SCALE: 8.5" x 14" - Legal Size

PREPARED BY: ECHO3GROUP.COM