SUITE 401

200 ELGIN STREET, OTTAWA, ON
(AS-BUILT FLOOR PLAN)

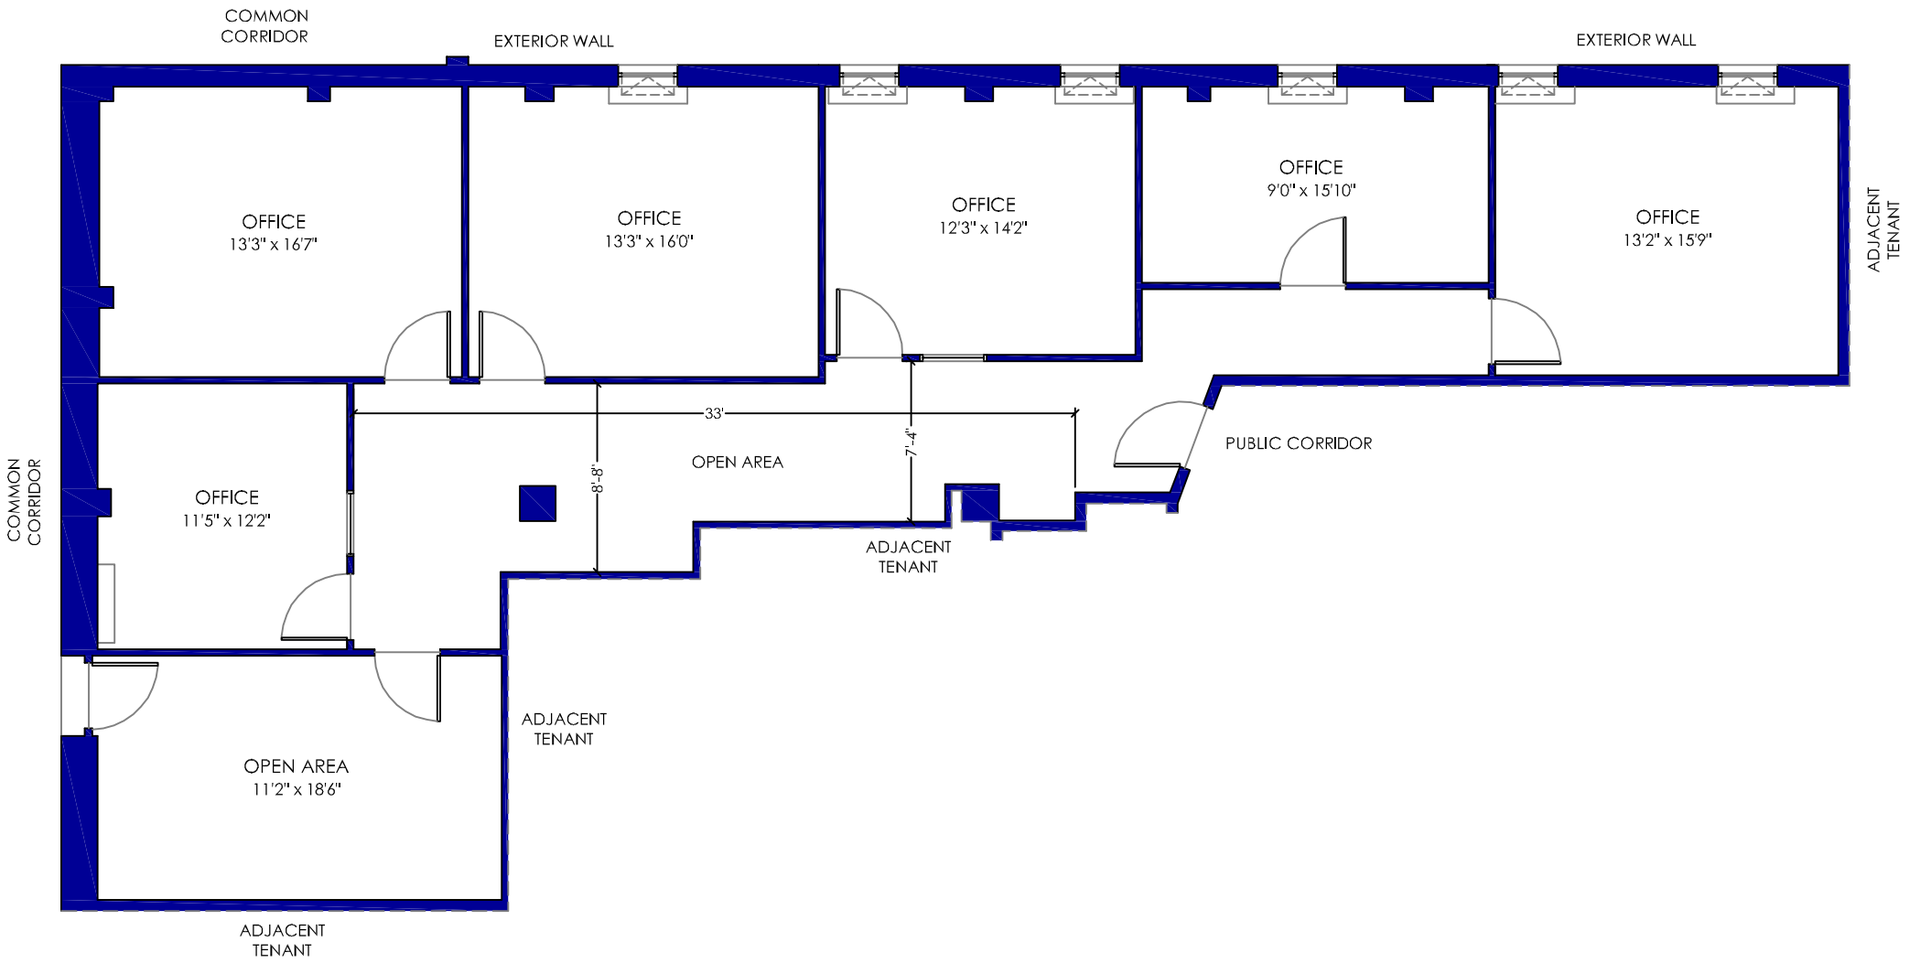

ORIENTATION

AERIAL VIEW

EXTERIOR VIEW

MAIN FLOOR LOBBY VIEW

0 5 10 15 FEET
0 1.52 3.05 4.57 METRES

PREPARED BY: **ECHO**FLOORPLANS.COM

PREPARED FOR: District Realty Corporation, Brokerage
ADDRESS: 200 Elgin St., Ottawa, ON
DATE: October 20, 2011
REVISION: n/a
PROJECT NUMBER: 100308
DRAWING SIZE: 8.5" x 14" - Legal Size

ECHO FLOOR PLANS
- As-Built Floor Plans
- Area Analysis
- Space Planning

www.**ECHO**FloorPlans.com