SUITE 301

126 YORK ST., OTTAWA, ON
(AS-BUILT FLOOR PLAN)

0 5 10 15 FEET
0 1.52 3.05 4.57 METRES

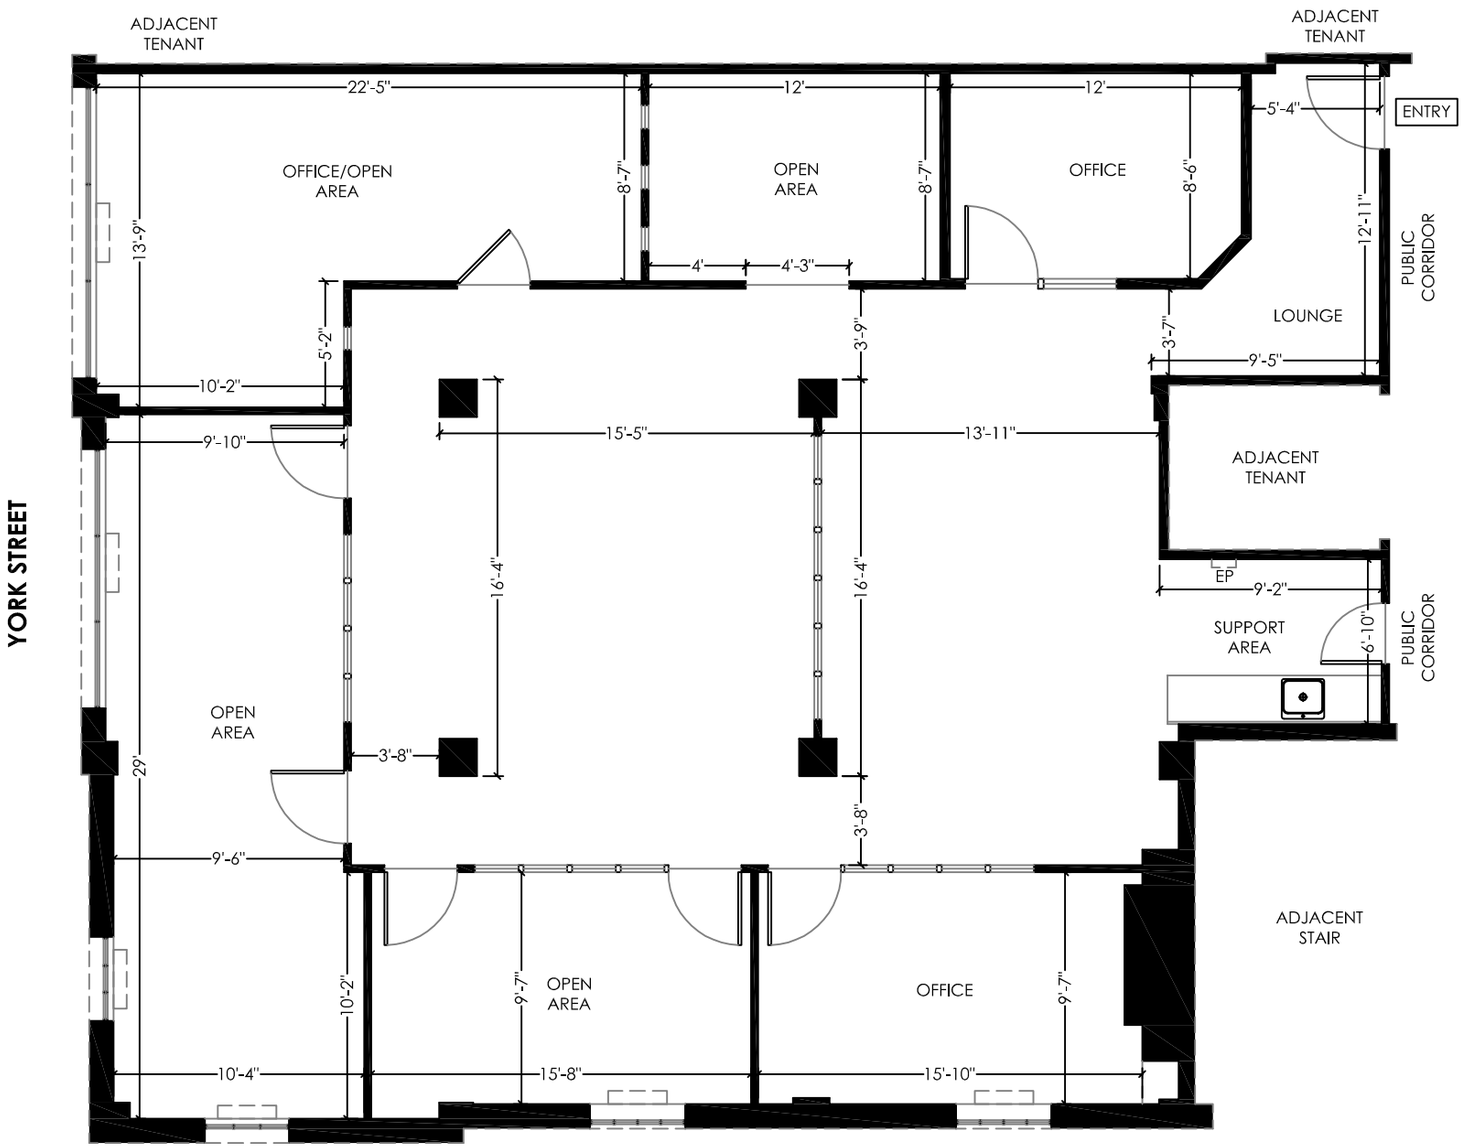

DRAWING ORIENTATION

AERIAL VIEW

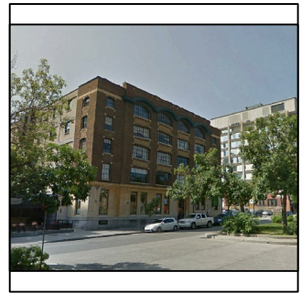

EXTERIOR VIEW

LEGEND:

- EXISTING WALLS
- EP ELECTRICAL PANEL
- TEL TELECOMMUNICATIONS

PREPARED FOR: District Reality Corporation, Brokerage
ADDRESS: 126 York St., Ottawa, ON
DATE: June 2, 2017
REVISION: n/a
PROJECT NUMBER: 200197
DRAWING SCALE: 8.5" x 14" - Legal Size

PREPARED BY: ECHO3GROUP.COM