ATKINSON SCHROETER DESIGN GROUP INC.
410 LAURIER AVENUE, SUITE 110, OTTAWA ONTARIO K1R 1B7 TEL (613) 563-3797 FAX (613) 234-0228 INFO@ASDGINTERIORS.COM

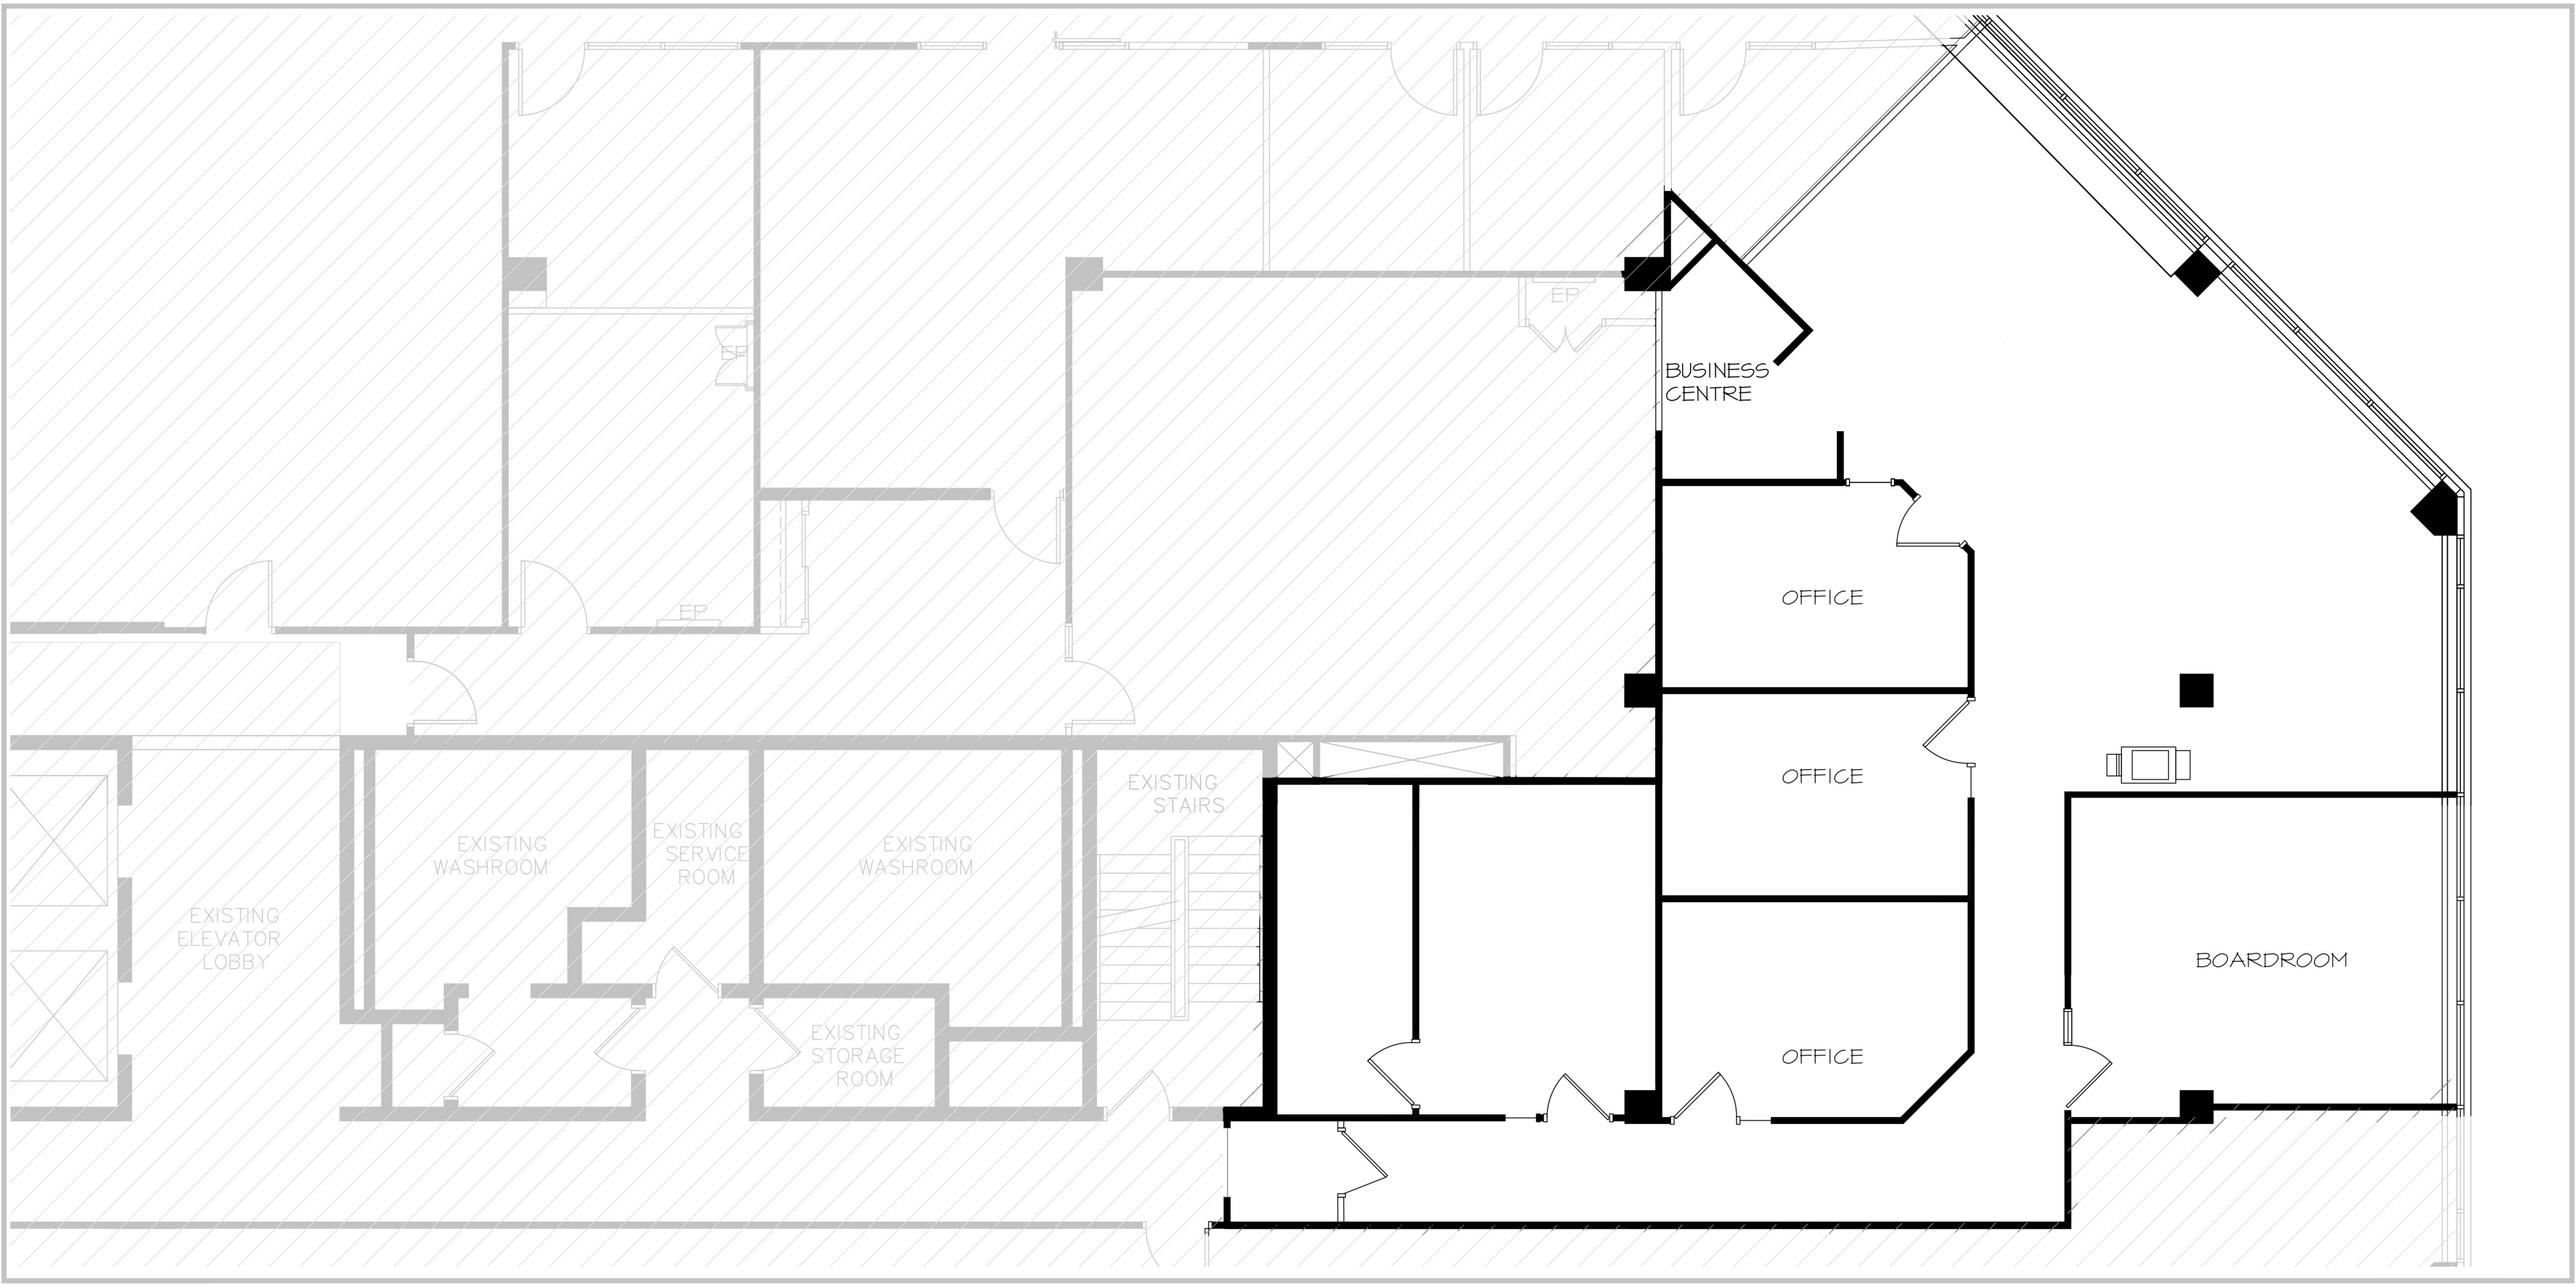

PROJECT	SCALE		DRAWN BY	CHECKED BY	
JDC APEX (MODIFIED SUITE) 1130 MORRISON DRIVE, 2ND FLOOR, OTTAWA	NTS	FOR PLANNING PURPOSES ONLY	KE	SAS	ASDG
DRAWING TITLE	DATE	JOB NO.	DRAWING NO.		
AS-BUILT PLAN	22.09.21	22068	AB01		