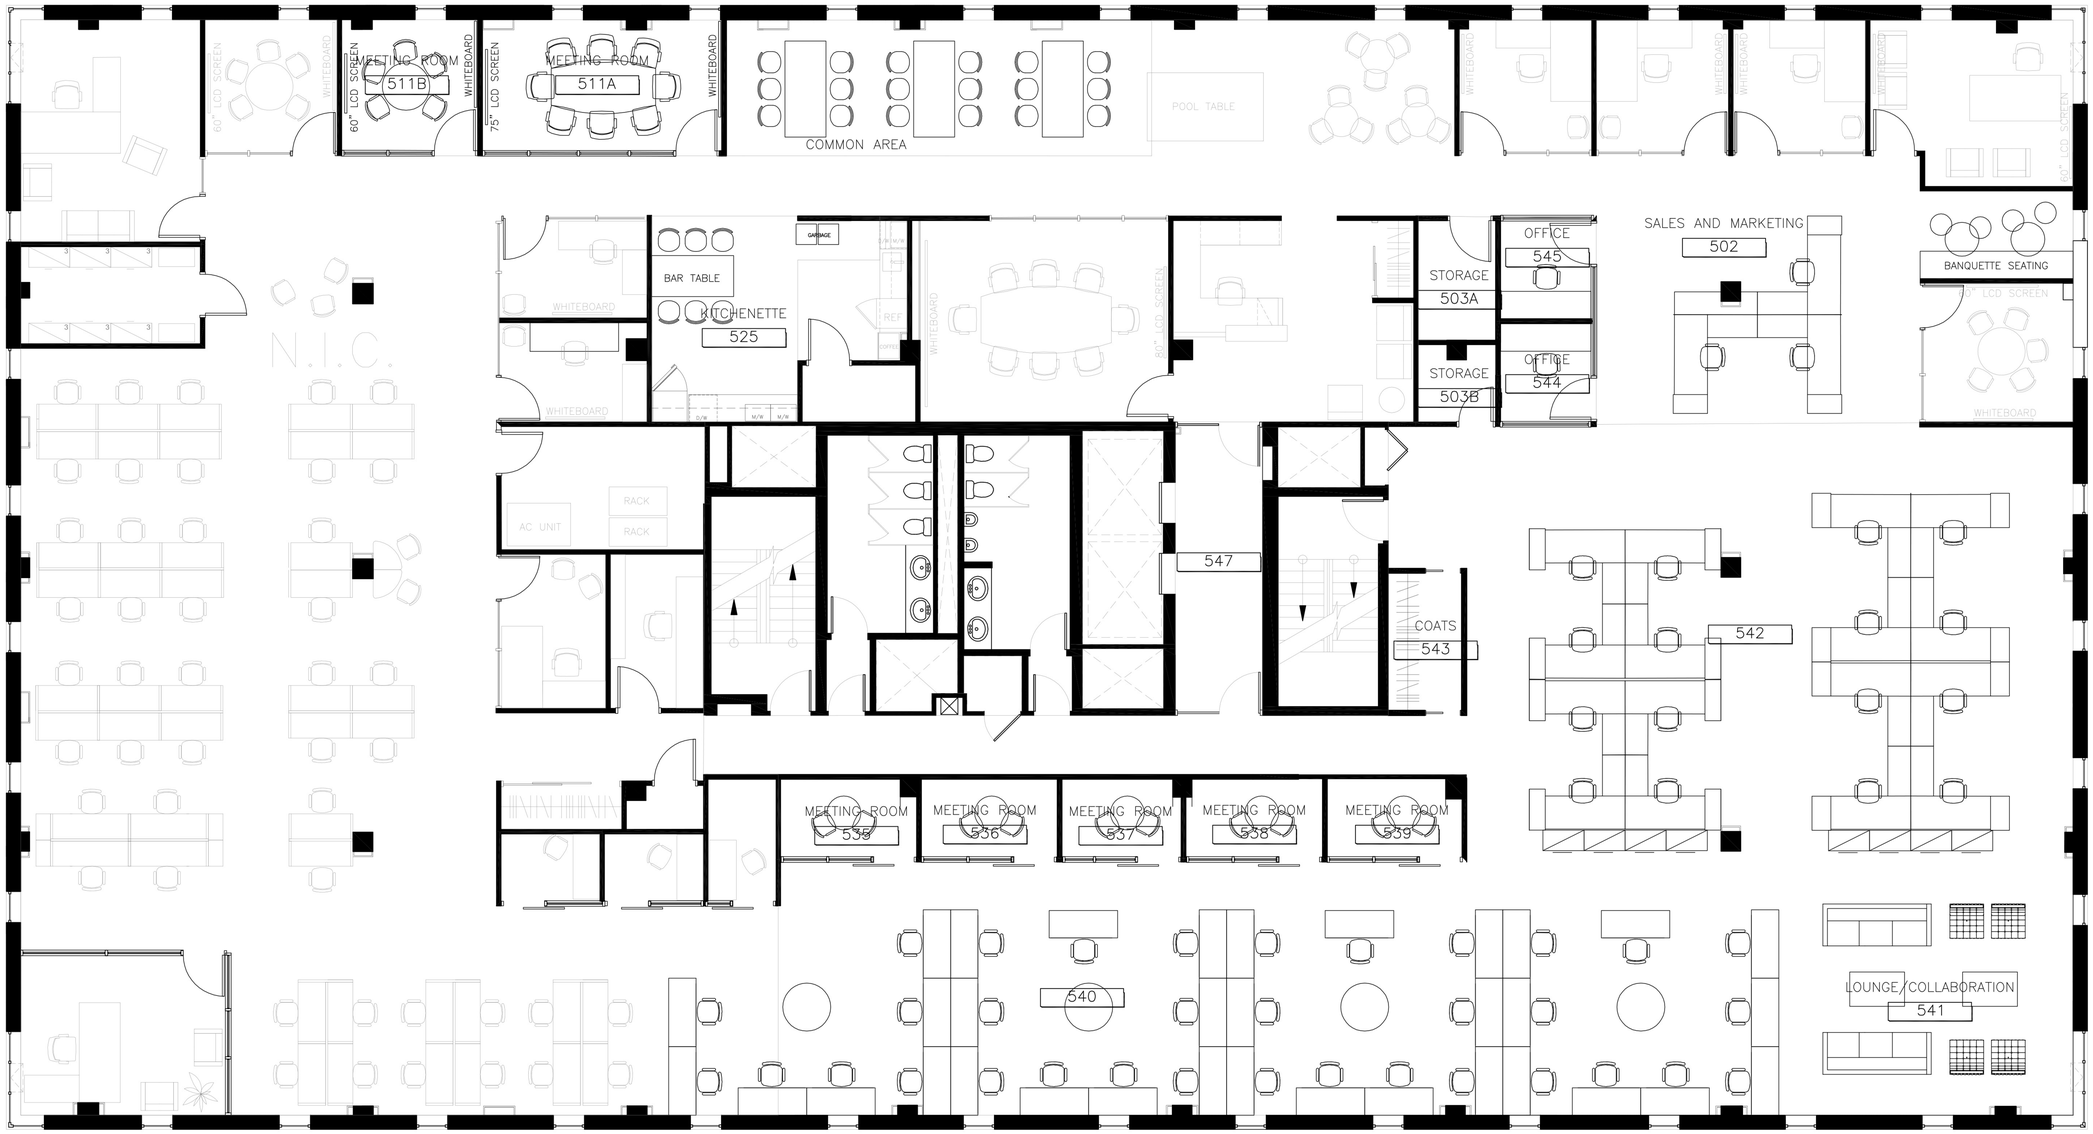

KEY PLAN

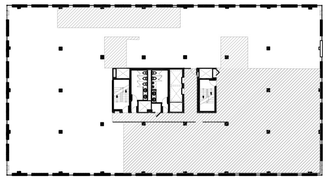

REV	DESCRIPTION	DATE
04	ISSUED AS BUILT	15/04/2016
03	ISSUED FOR CONSTRUCTION	23/09/2015
02	ISSUED FOR PERMIT & TENDER	08/09/2015
01	ISSUED FOR 99% REVIEW	03/09/2015

REVISION TABLE

THIS DRAWING TO BE READ IN CONJUNCTION WITH THE CONSTRUCTION MANUAL.

THIS DRAWING IS THE PROPERTY OF 4TÉ INC. AND ALL COPYRIGHT IS RESERVED.

CE DESSIN EST LA PROPRIETÉ DE 4TÉ INC. ET TOUS DROITS DE RÉPRODUCTION SONT RESERVES.

DIMENSIONS ON THIS DRAWING FOR ESTIMATING PURPOSES ONLY. IT IS THE RESPONSIBILITY OF EACH CONTRACTOR AND SUB-CONTRACTOR TO CHECK ALL DIMENSIONS AND CONDITIONS ON SITE.

LES DIMENSIONS SUR CE DÉSSIN SONT UNIQUEMENT POUR ÉTABLIR UN DÉVIS. LES ENTREPRENEURS DEVRONT PRENDRE LEURS PROPRE MESURES SUR LES LIEUX ET EN ÊTRE RESPONSABLES.

4TÉ INC. BCIN#

28700

SIGNATURE: BCIN#

4TÉ
73 Breezehill Avenue North
Ottawa, ON K1Y 2H6
tel: 613.232.4499
fax: 613.232.4187
www.4te.ca

Project Title / Titre du Projet

i-SIGHT CUSTOMER EXPRESSIONS EXPANSION 2015
2255 CARLING AVE
SUITE 500
OTTAWA, ONTARIO

Drawing Title / Titre du Dessin

FURNITURE PLAN

Date: AUGUST 12, 2015	Scale / Échelle 1/8" = 1'
Drawn by / Tracé par MM	Checked by / Vérifié par NS
N	Reference / Réference CEC-4370
	Drawing No.: D-01